


#301 DIAMOND HEAD - 40120 WILLOW DRIVE
SQUAMISH

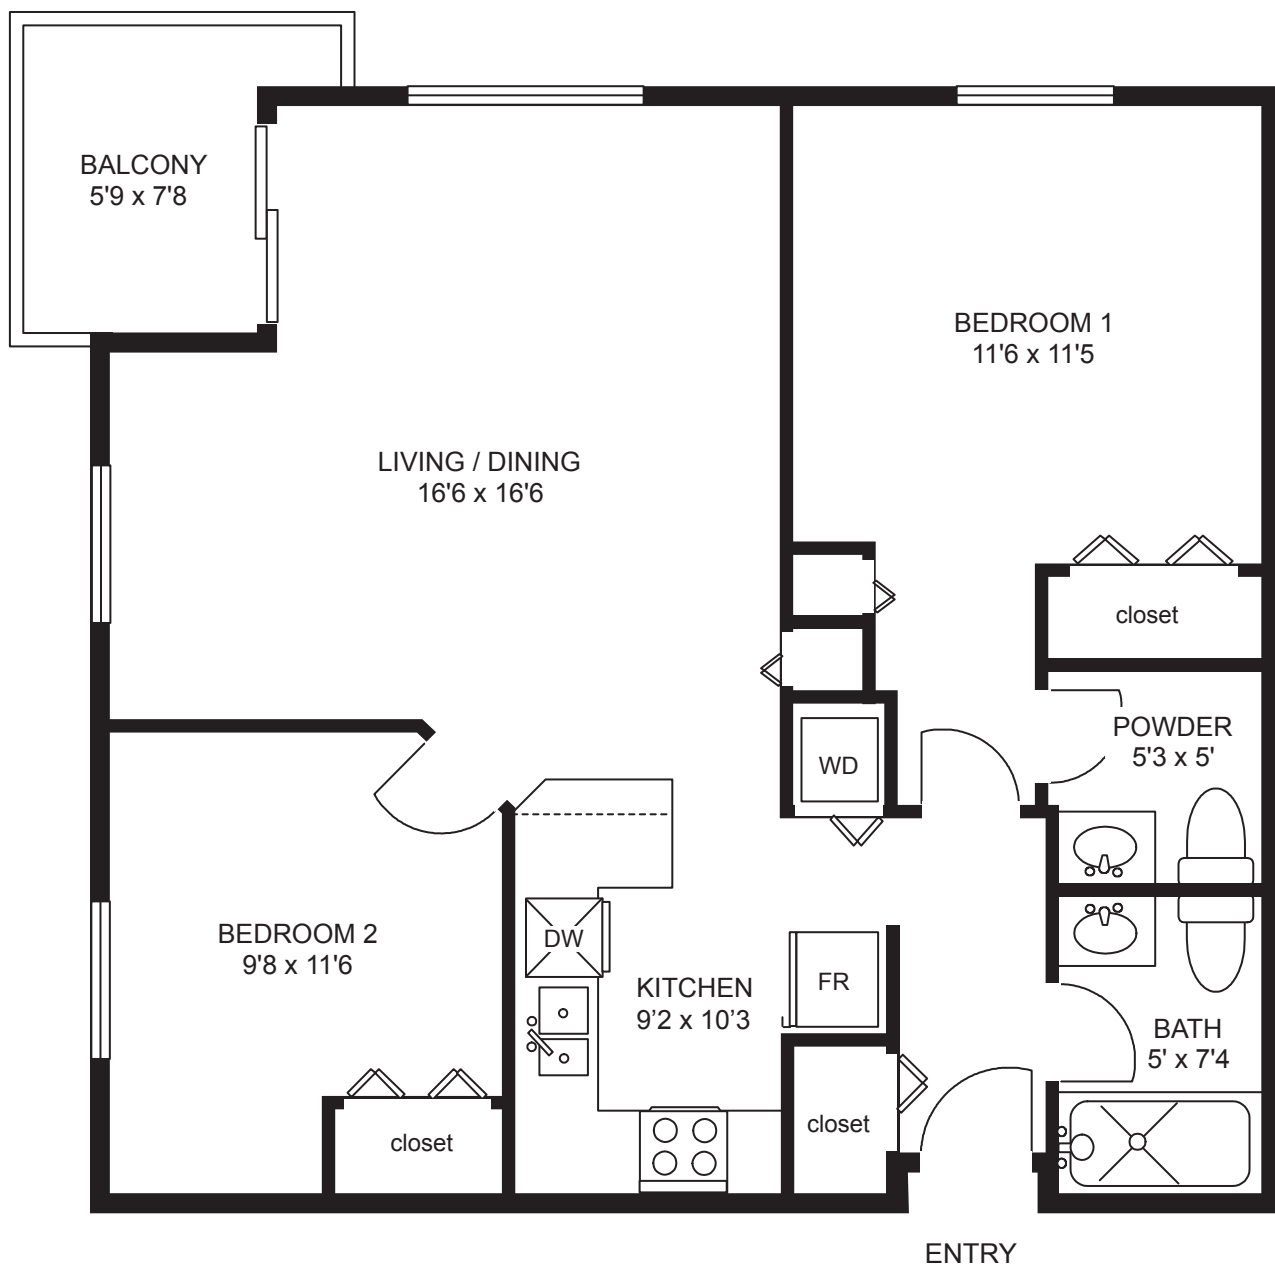

800 SQ FT
plus 50 sq ft Balcony

RON SLOAN
rsloan@sothebysrealty.ca
778.229.3485



INSIDE ADVANTAGE Area includes approximately half (3") of all exterior and shared walls

These As-Built plans are intended to be used for marketing purposes and are indicative only. Although all due care is taken in the preparation of these drawings all details and measurements should be deemed approximate and used for informational purposes only. Responsibility for any errors and omissions is expressly denied. Inside Advantage makes no representations regarding the legality of the spaces illustrated. All interested parties should make their own enquires. E&OE. Copyright Inside Advantage, not to be transferred or reproduced without written consent.